

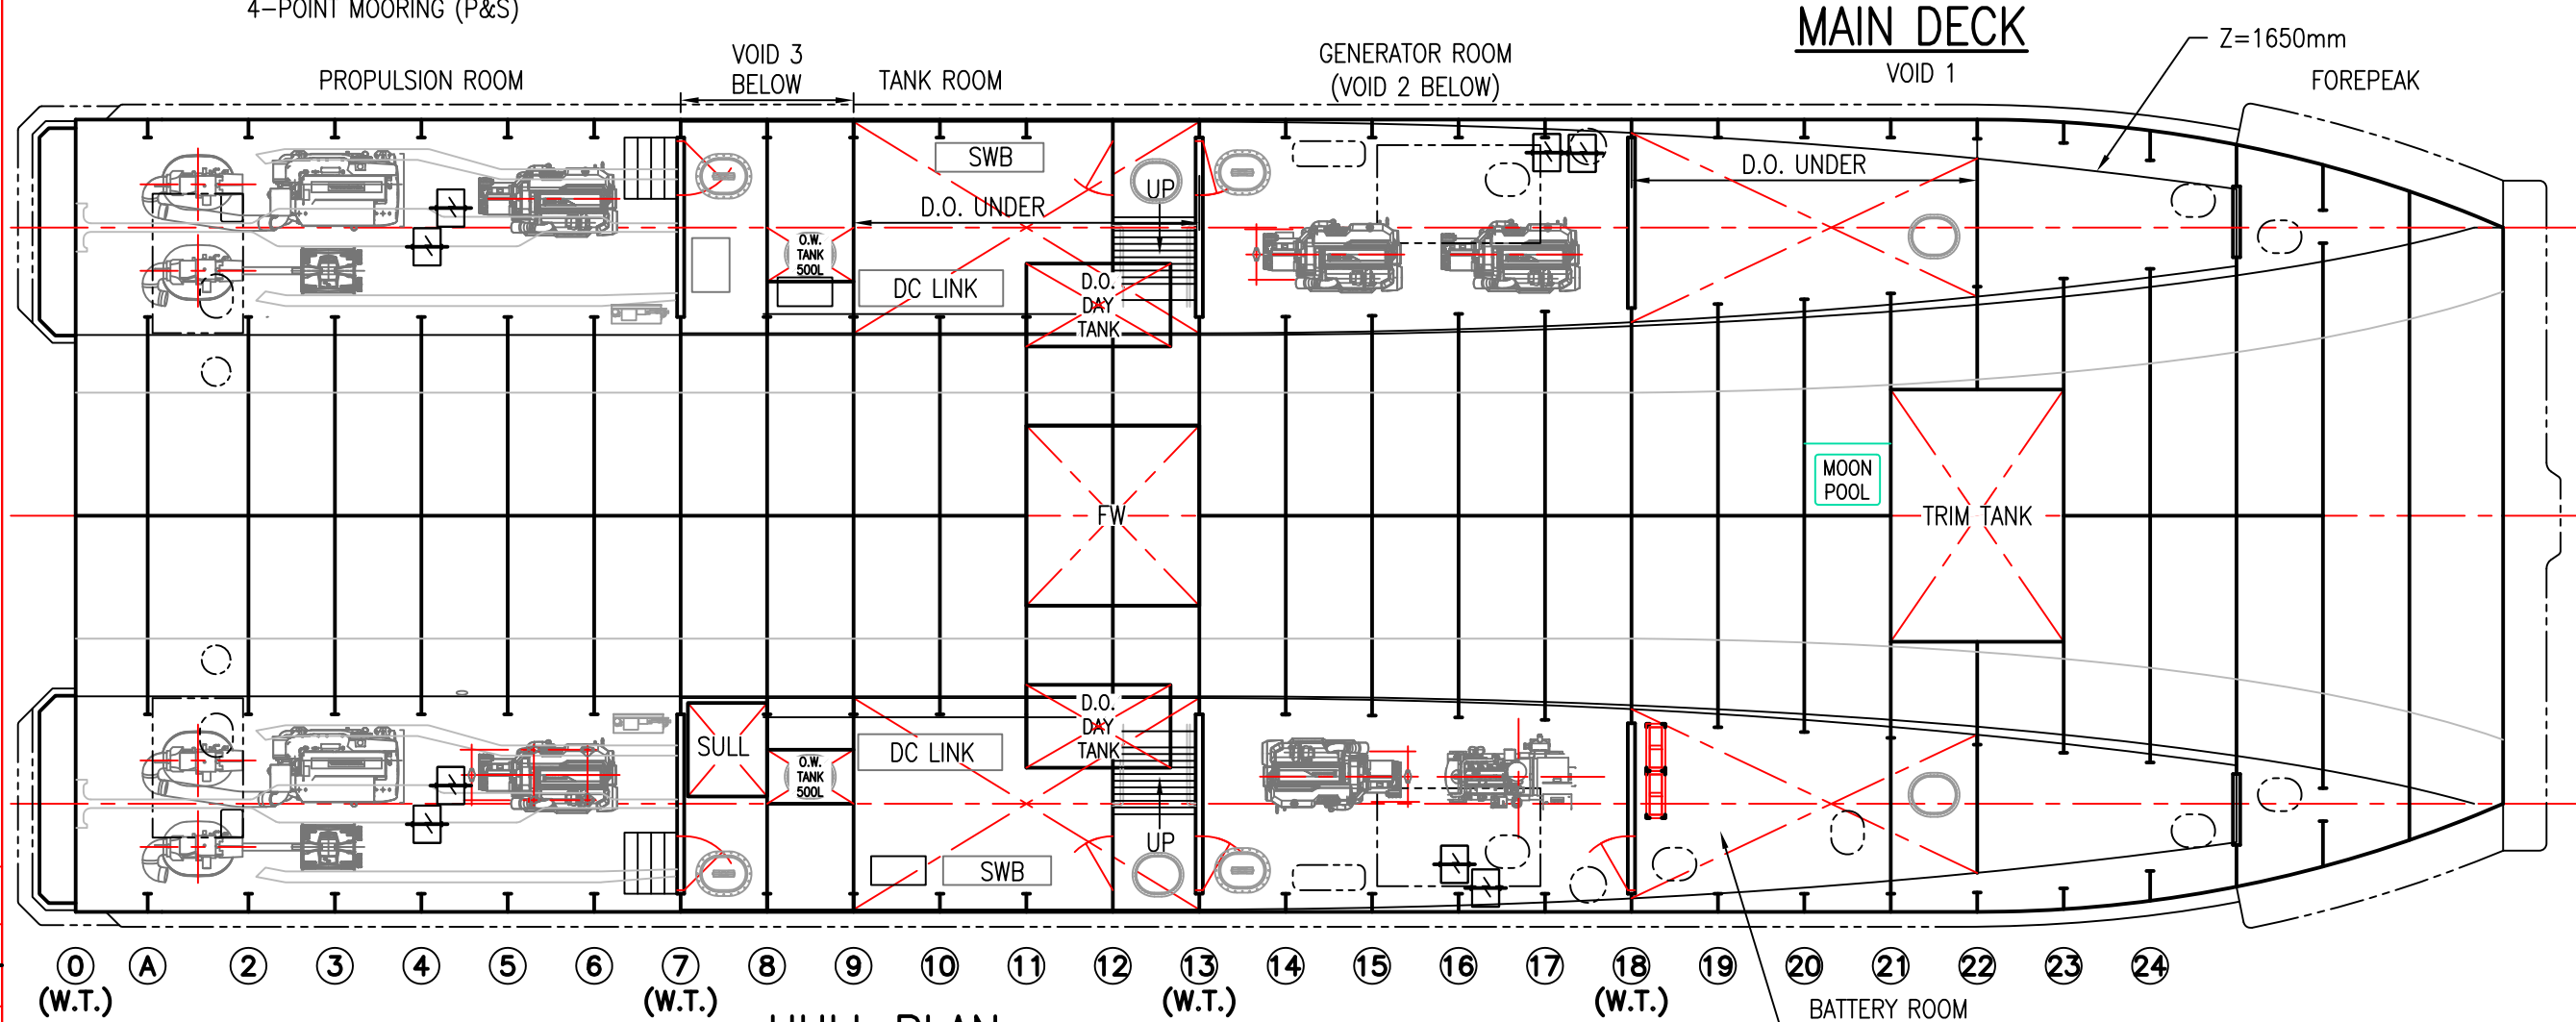
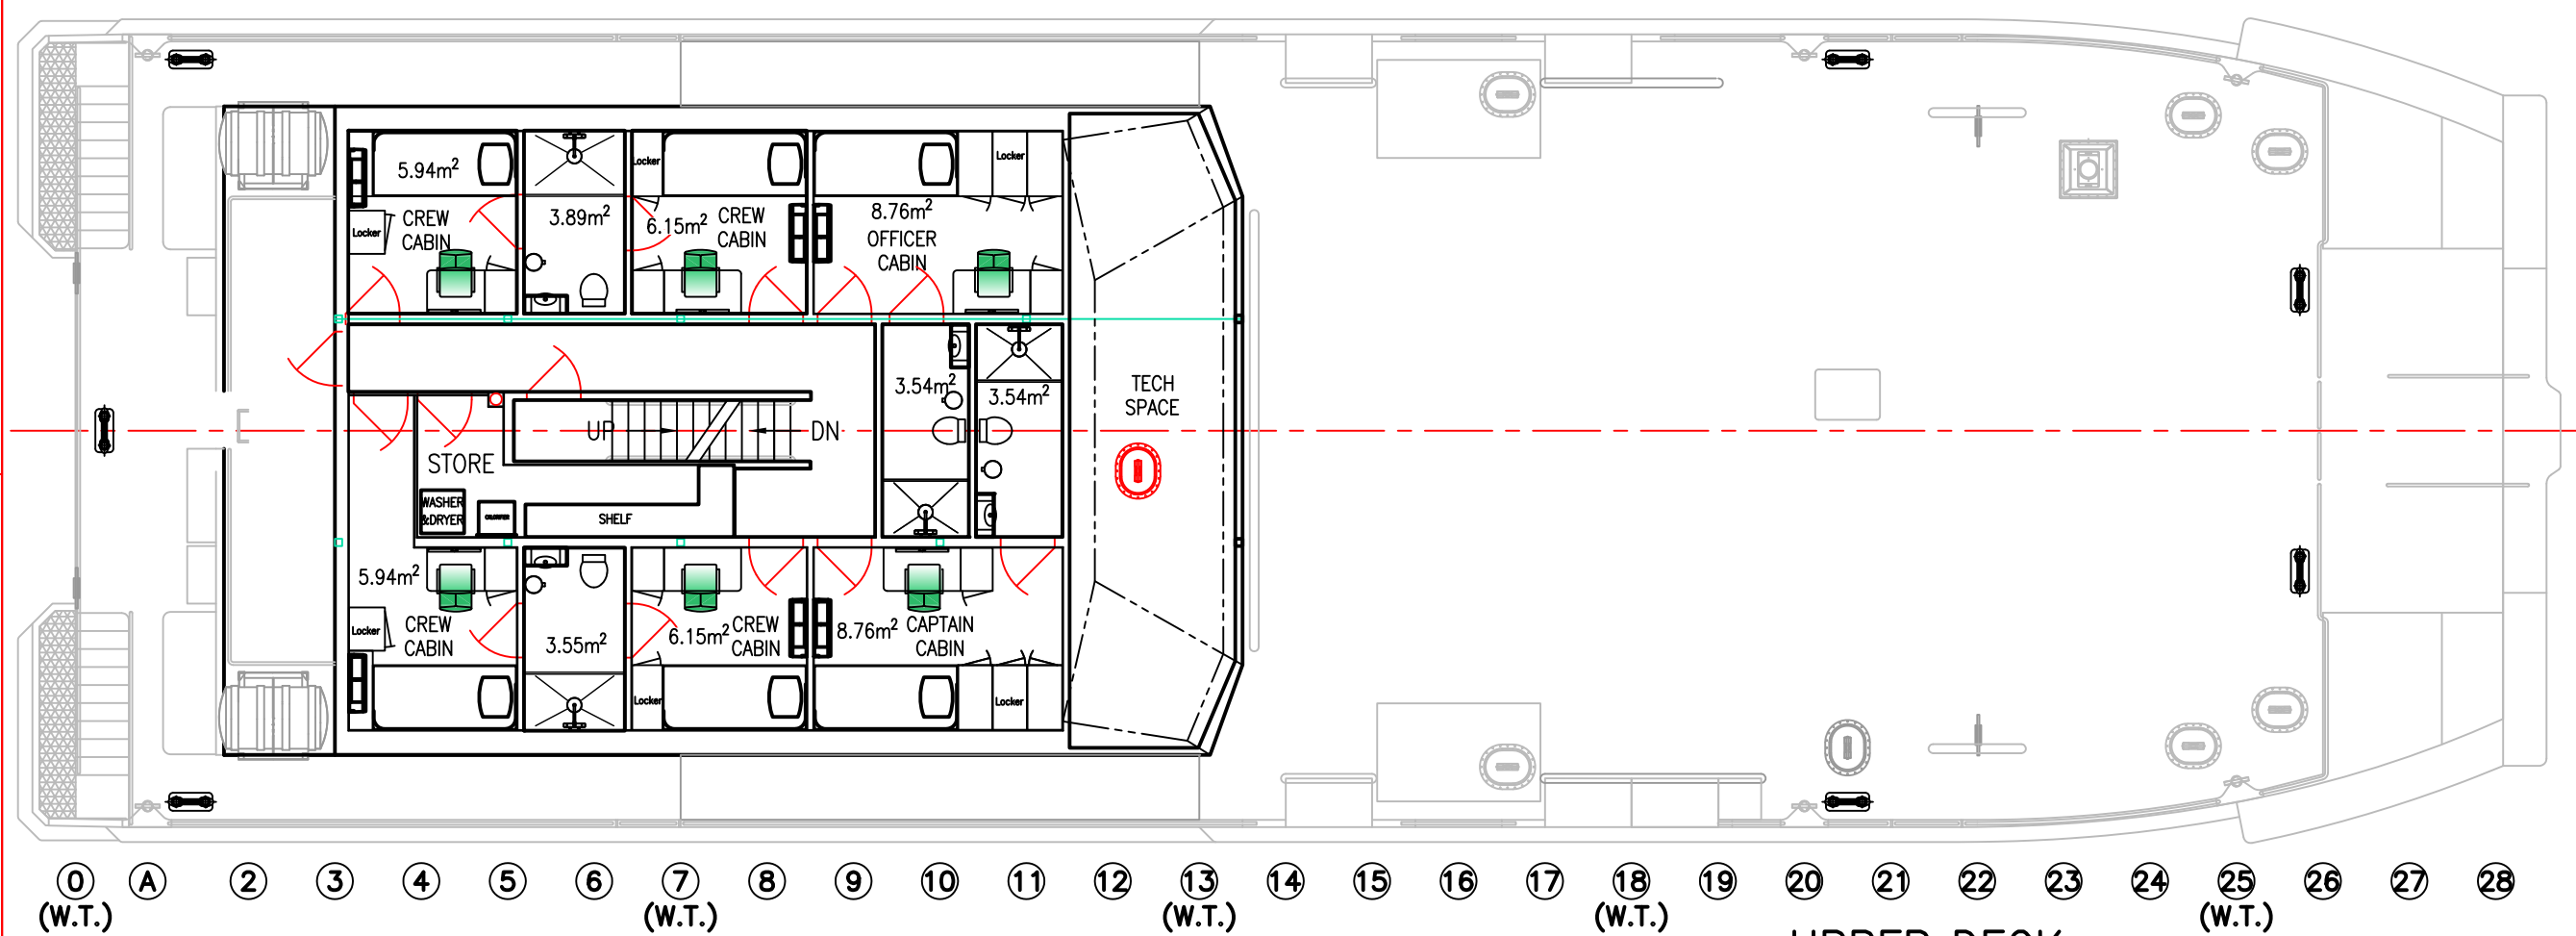
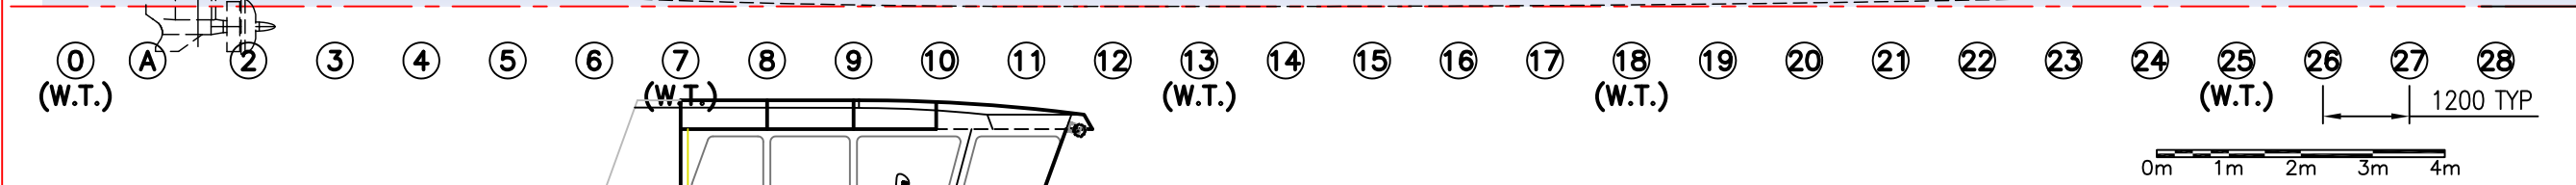


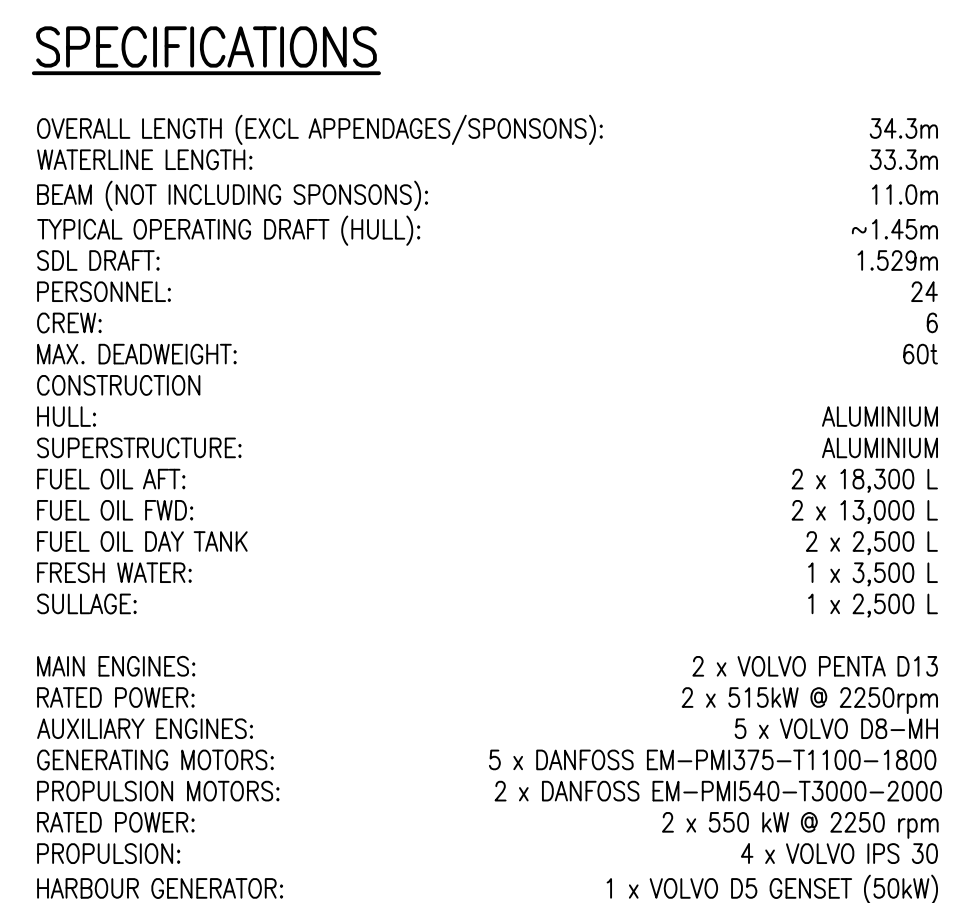

Technical drawing of the SMHO-Co ship hull and superstructure. The drawing shows the hull form, deck, and various equipment. The hull is labeled 'SMHO-Co' and 'SMHO-Co' on the side. The drawing includes a red dashed line indicating the centerline. The hull is shown in a cross-section view, with the deck and superstructure visible. The drawing is a technical illustration of a ship's hull and superstructure.

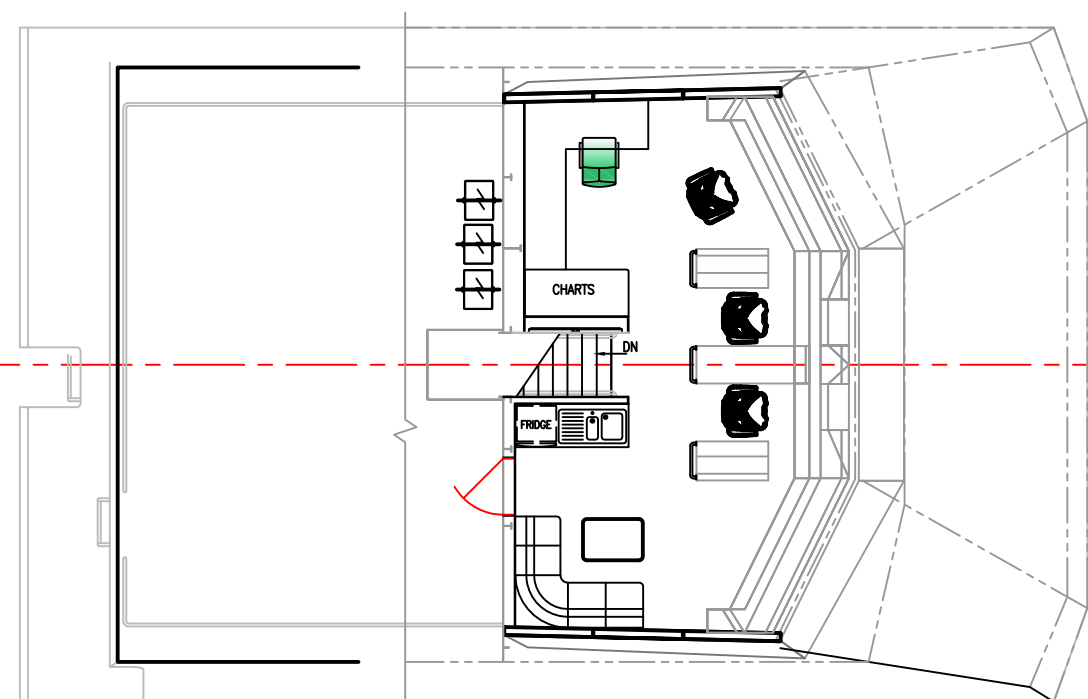

HULL No. 船体编号		MHO ASGARD				DRAWING No. 图号	
ASA102						ASS2004-050-001	
DESIGNED 设计	LX	20210421	GENERAL ARRANGEMENT				DESIGN STATE 设计阶段
CHECKED 校对	MJL	20210421					AS BUILT
VERIFIED 审核	YCM	20210421					REV. VER. 修改版本
CERTIFIED 校核	MJL	20210421					
APPROVED 审批	XGN	20210421	MATERIAL 材料	WEIGHT(kg) 重量	SCALE 比例	PAPER SIZE 图幅	第 1 页 共 1 页
			-	-	1:100	A1	