




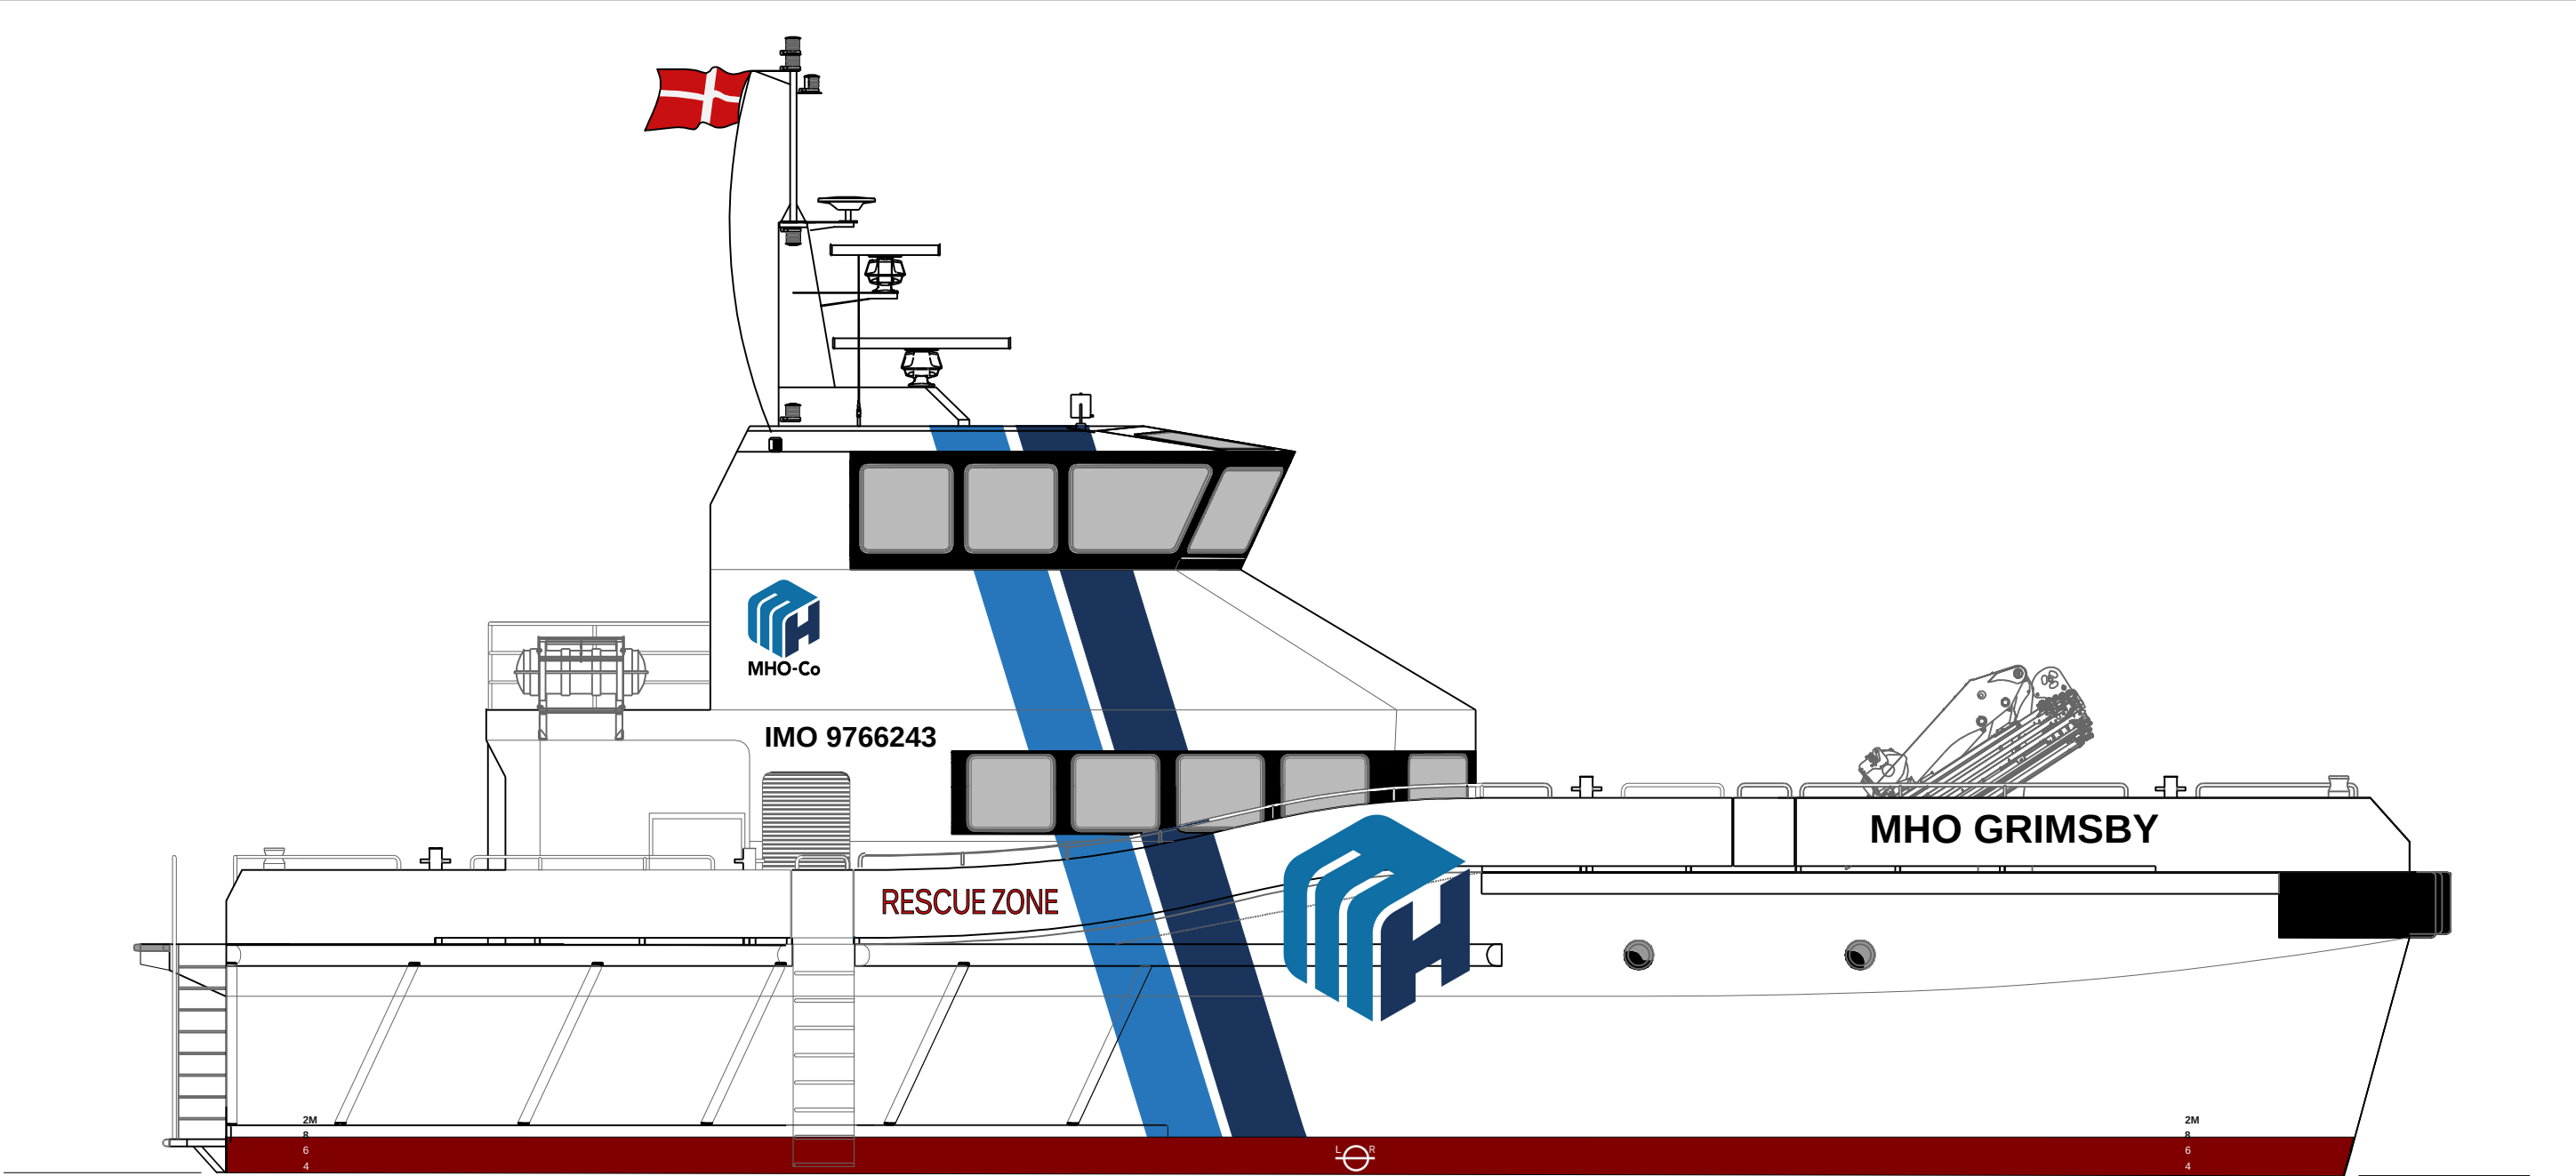


OUTBOARD PROFILE

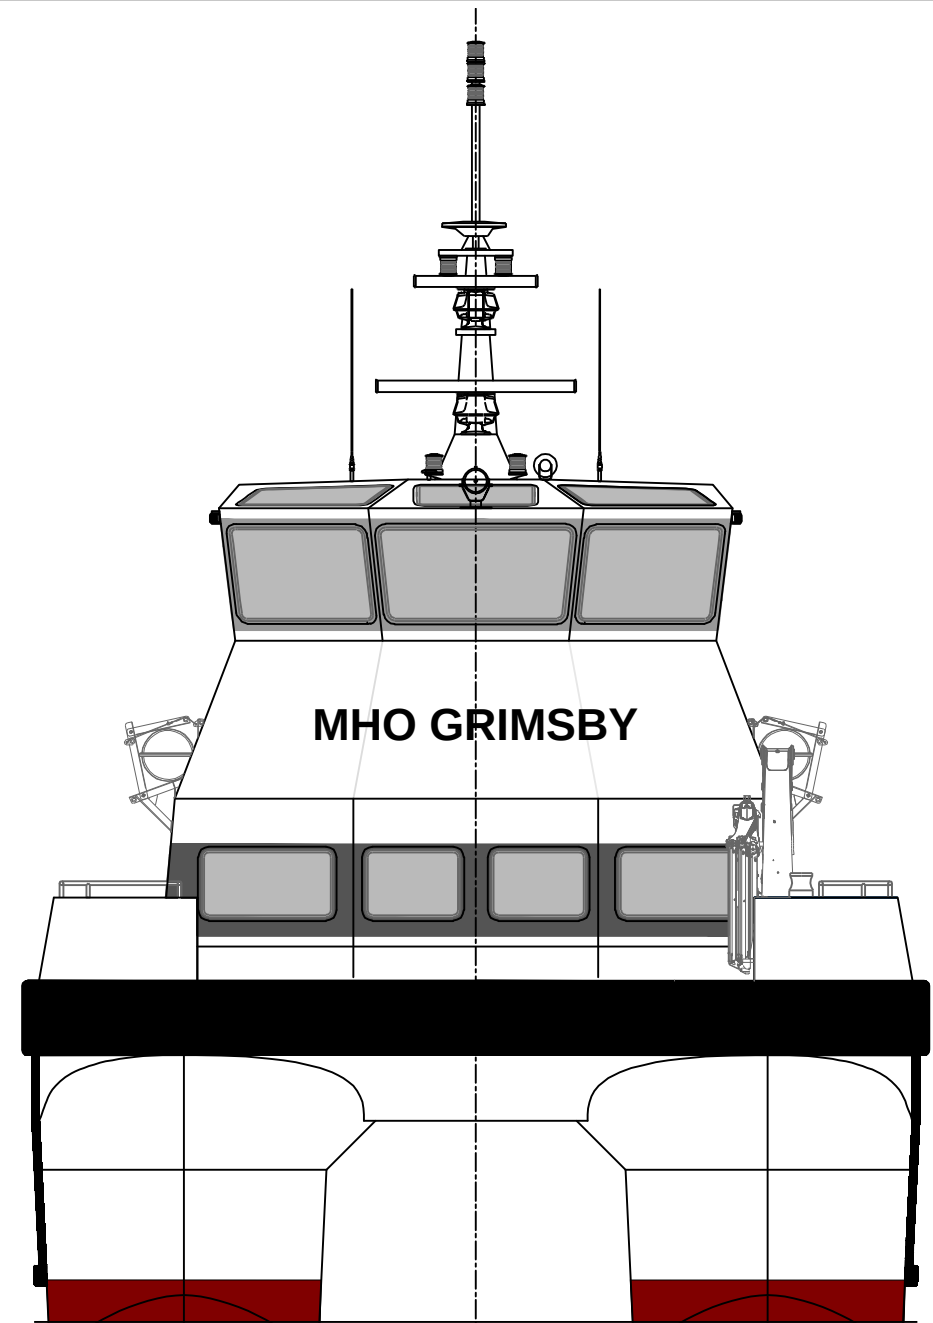

VIEW ON BOW

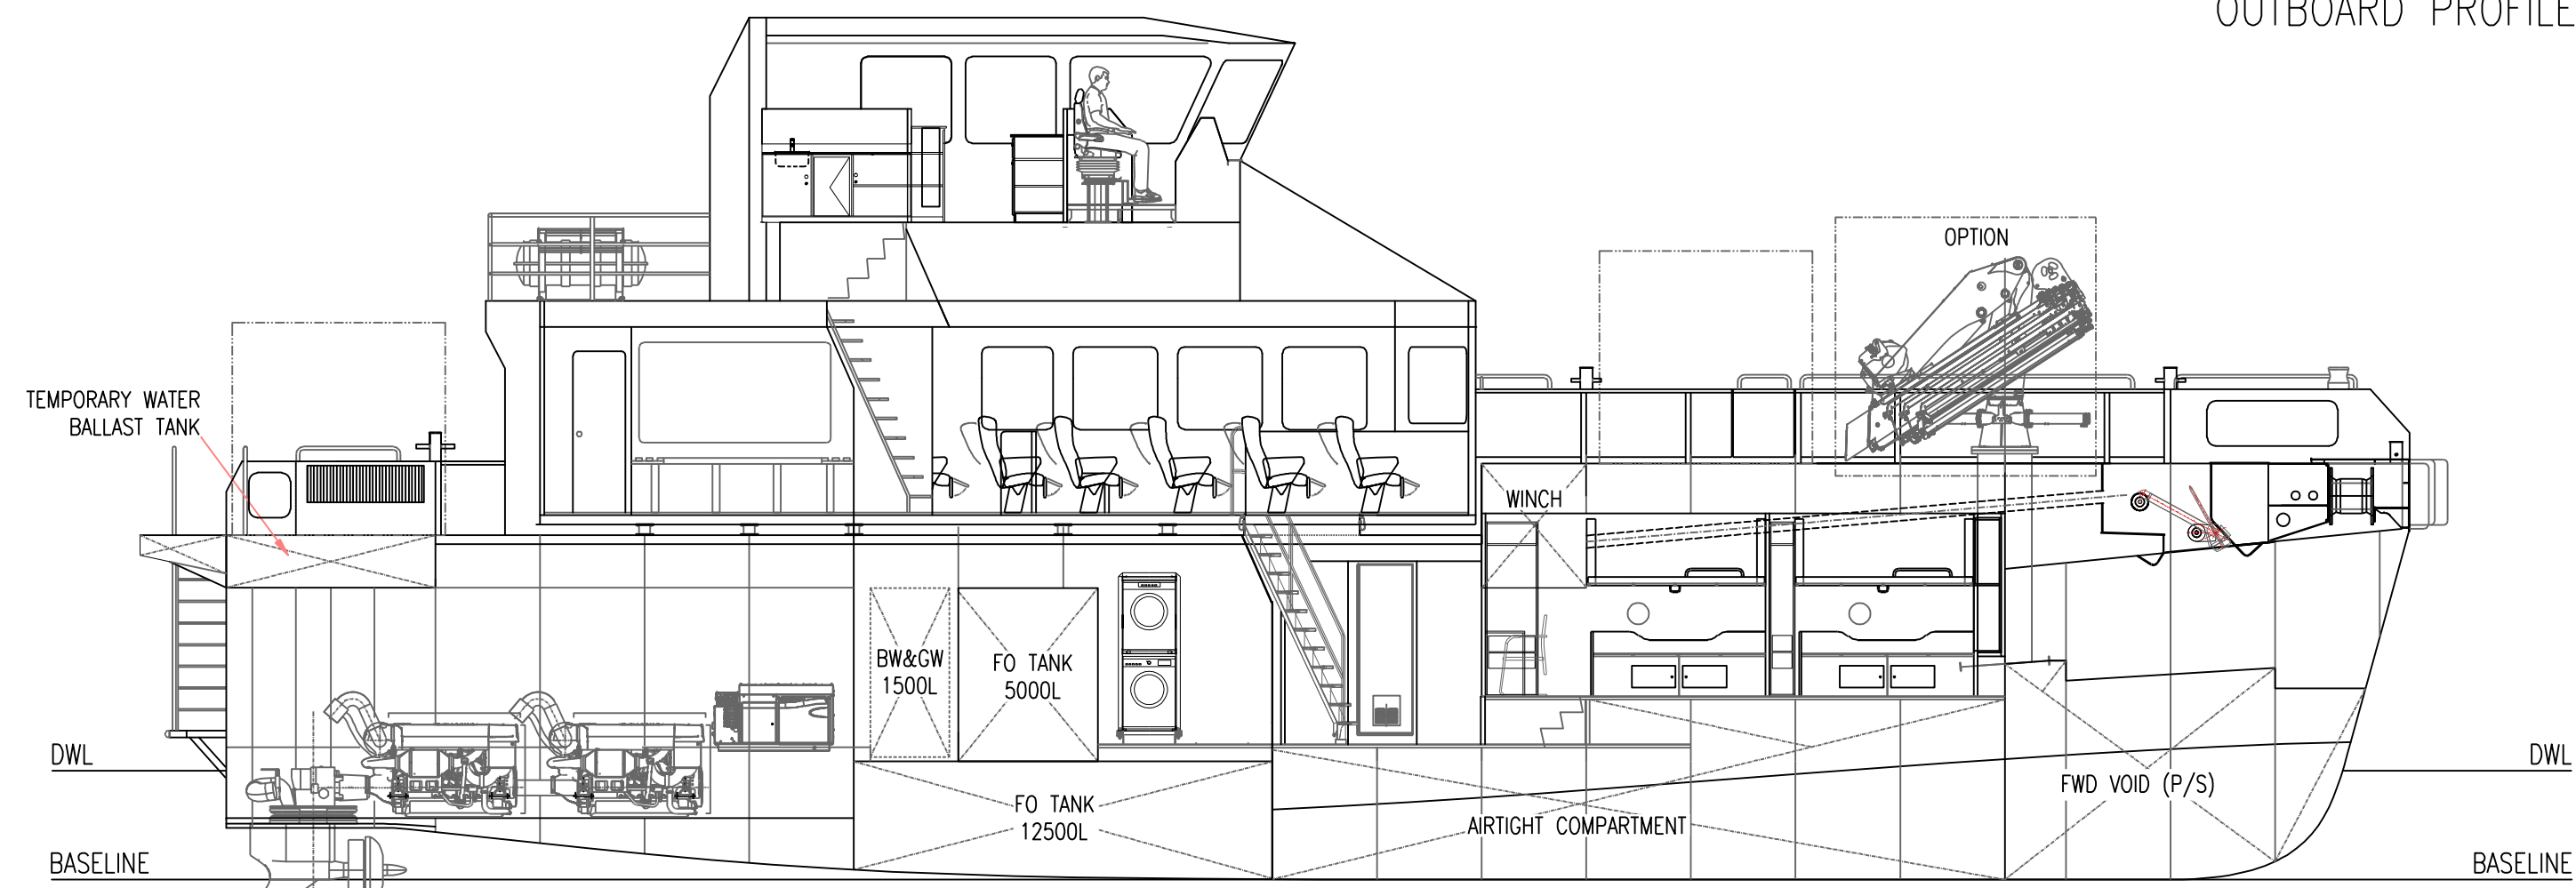

INBOARD PROFILE

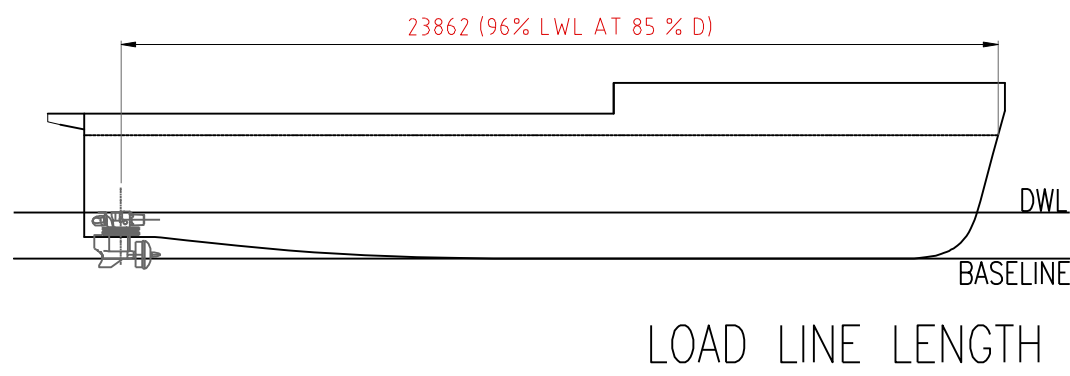

LOAD LINE LENGTH



DRAWING REF: SM227-15-001 REVISION: L HULL NO: H202

PRINCIPAL PARTICULARS


LENGTH OVERALL:	26.2 m
LOAD LINE LENGTH:	23.8 m
LENGTH WATERLINE (DESIGN):	24.3 m
MAXIMUM MOULDED BEAM:	8.9 m
BEAM DEMIHULL CL - DEMIHULL CL:	5.95 m
HULL DESIGN DRAFT:	1.3 m
HULL SCANTLING DRAFT:	1.5 m
SCANTLING DRAFT (UNDERSIDE OF SKEG):	1.7 m
FUEL:	35000 L
FRESH WATER:	3000 L
BLACK WATER:	1500 L
CREW CAPACITY:	4
INDUSTRIAL PERSONNEL:	24 (WHERE THE NUMBER OF PASSENGERS CARRIED ON BOARD MAY NOT EXCEED 12)

CLASS:	LRS#100A1, SSC, WORKBOAT, CATAMARAN, HSC, G3 MCH GERMAN
FLAG:	GERMAN
MAX DEADWEIGHT:	30t
AFT CARGO AREA:	27m ²
FWD CARGO AREA:	50m ²
DECK LOADING:	2t/m ²
BALLAST TANK:	2500 L


MACHINERY / PERFORMANCE

MAIN ENGINES: 4x VOLVO PENTA IPS 900


SPEED @ 100%MCR 10t DWT :	27 kts
SPEED @ 85%MCR 10t DWT :	25 kts

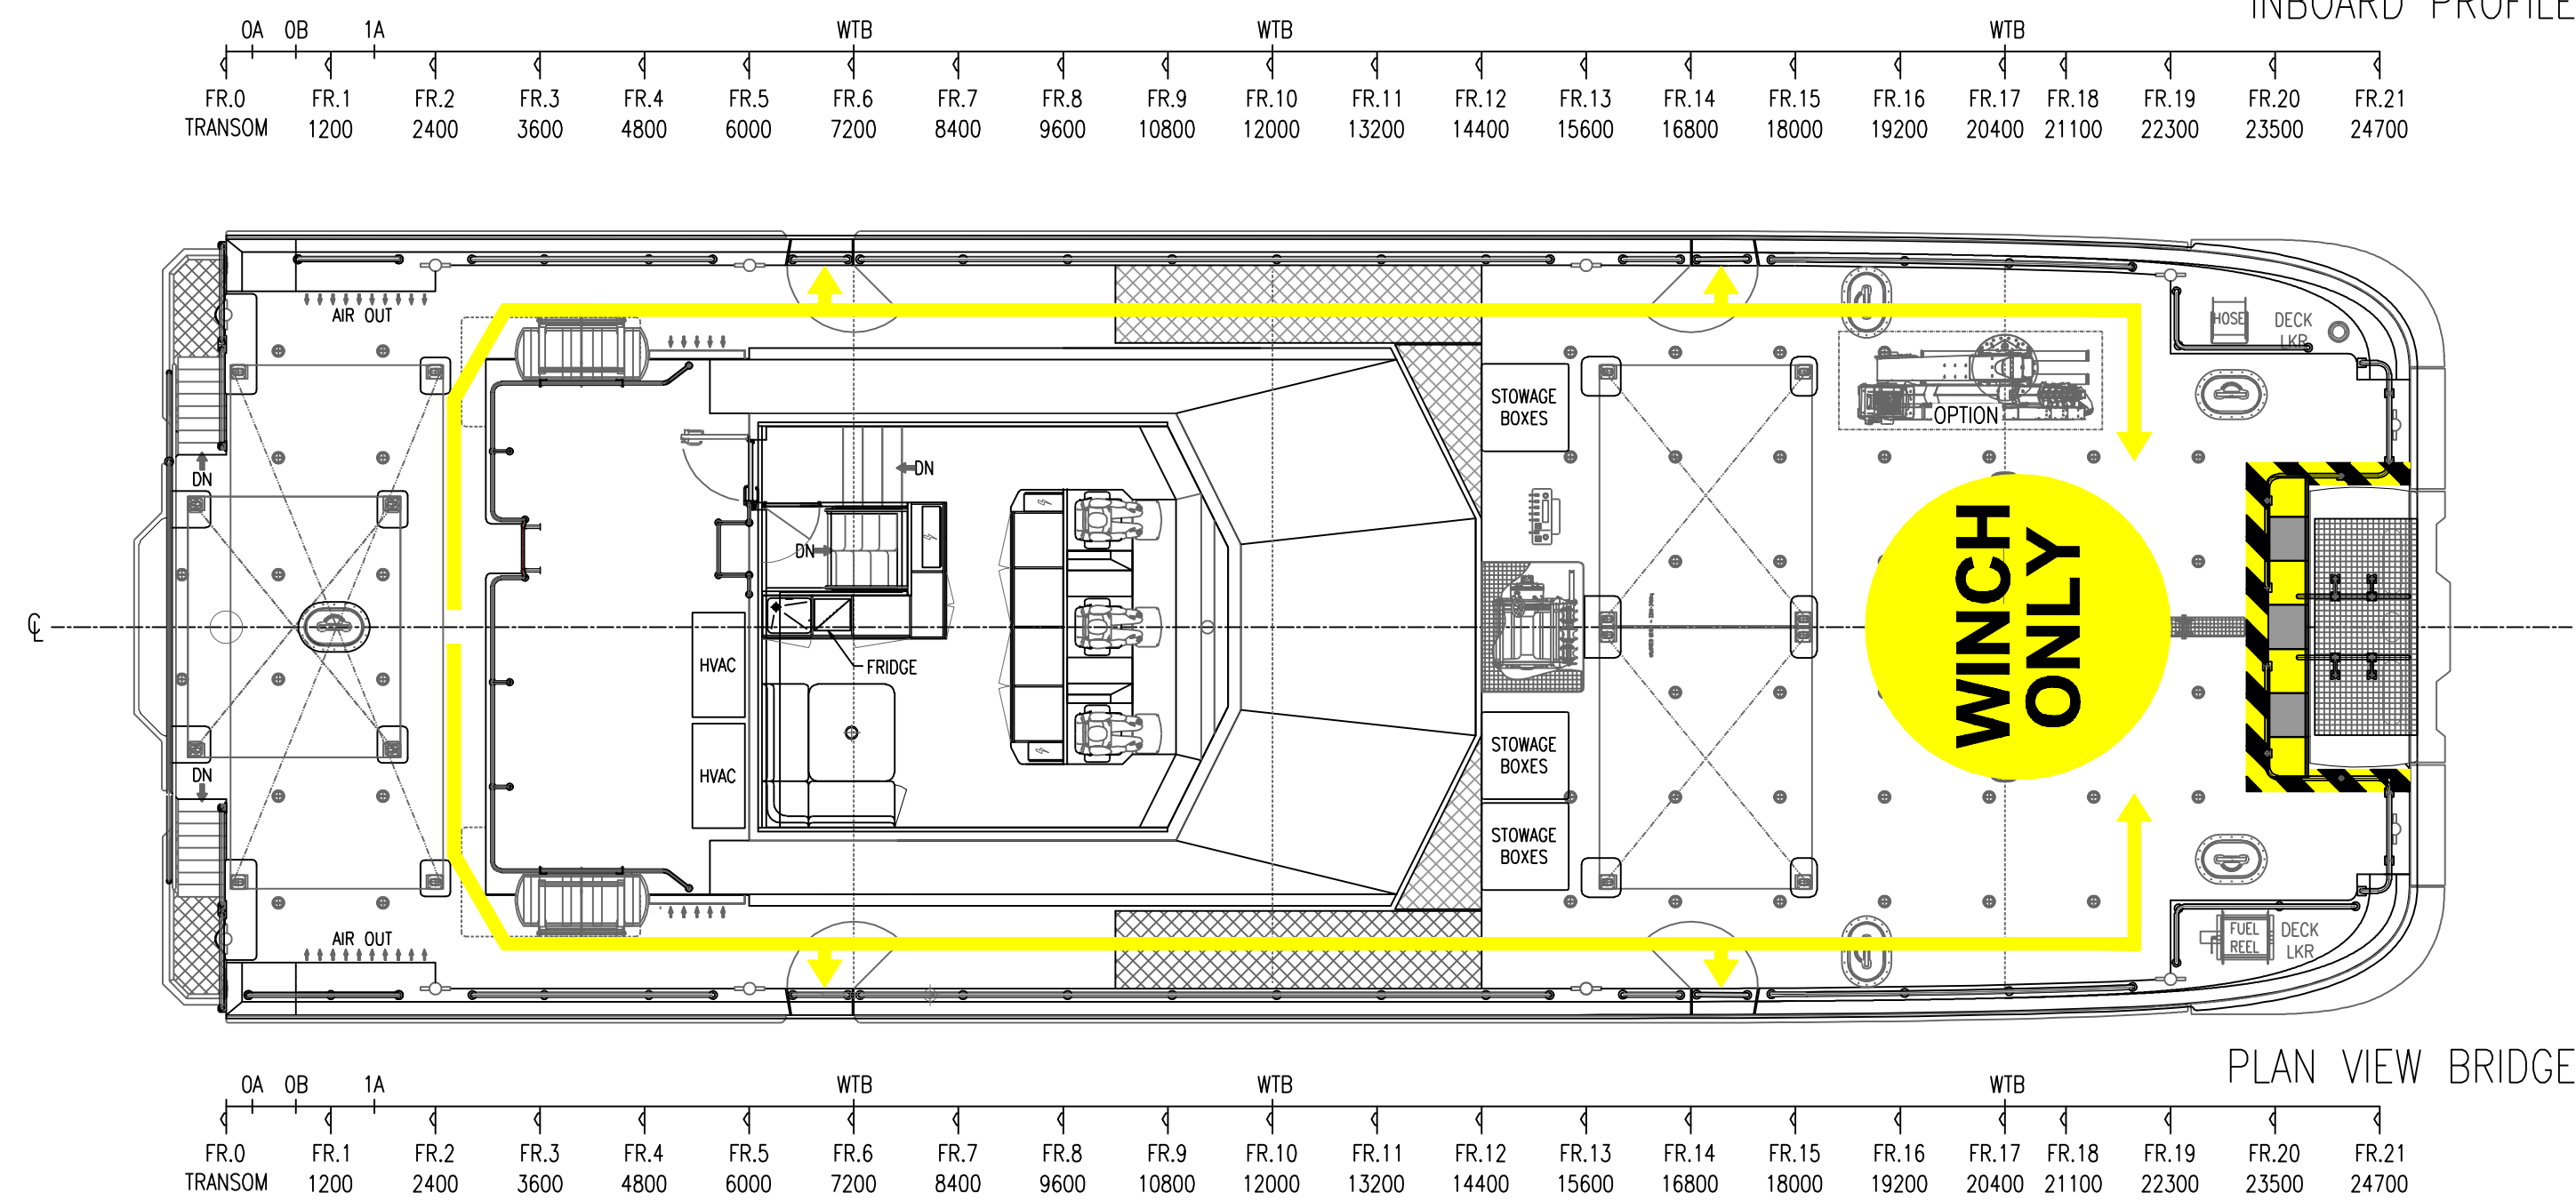

PLAN VIEW BRIDGE

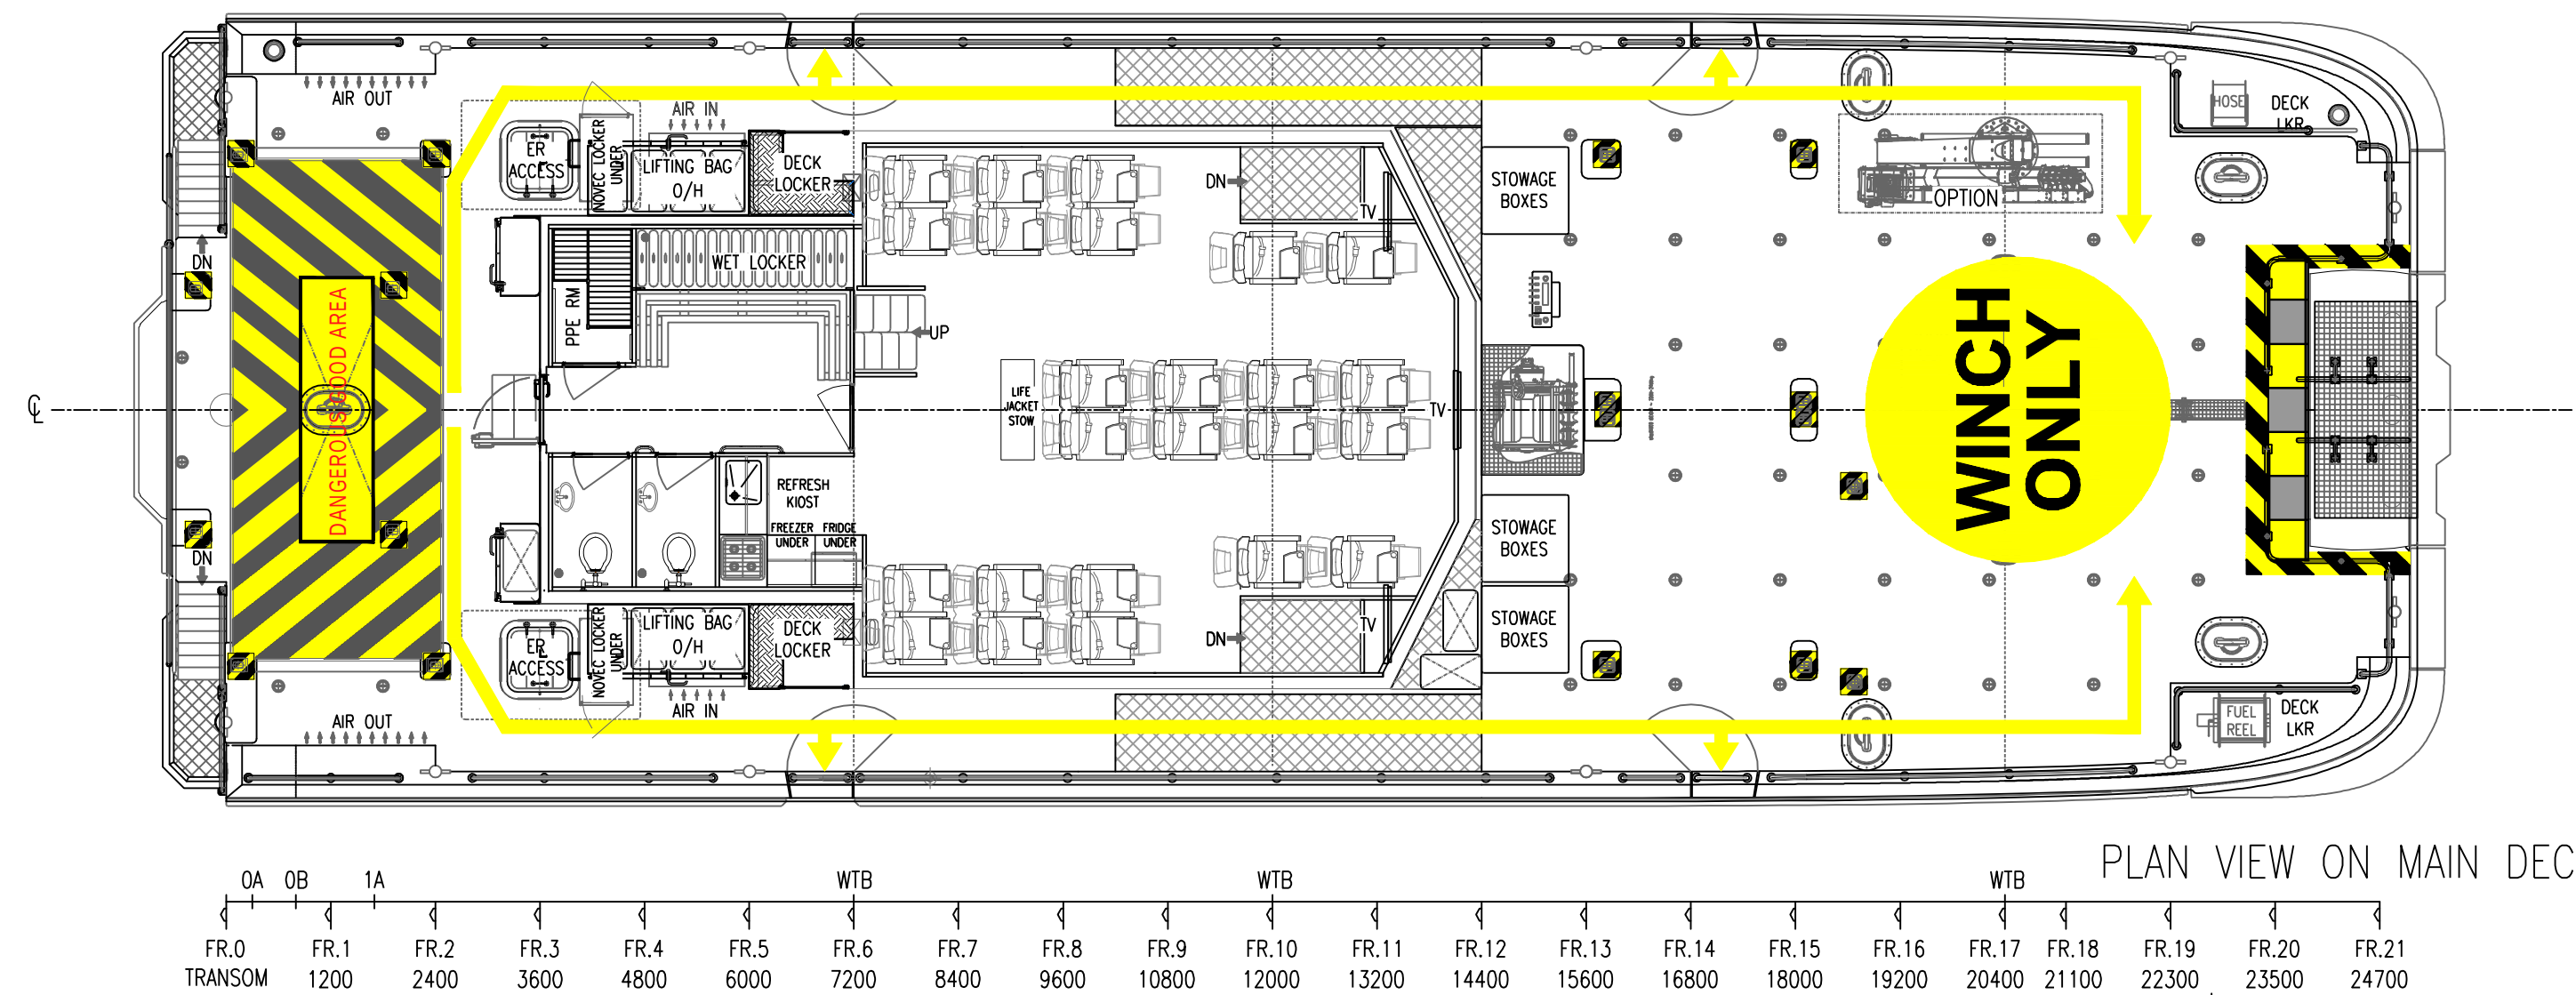

PLAN VIEW ON MAIN DECK

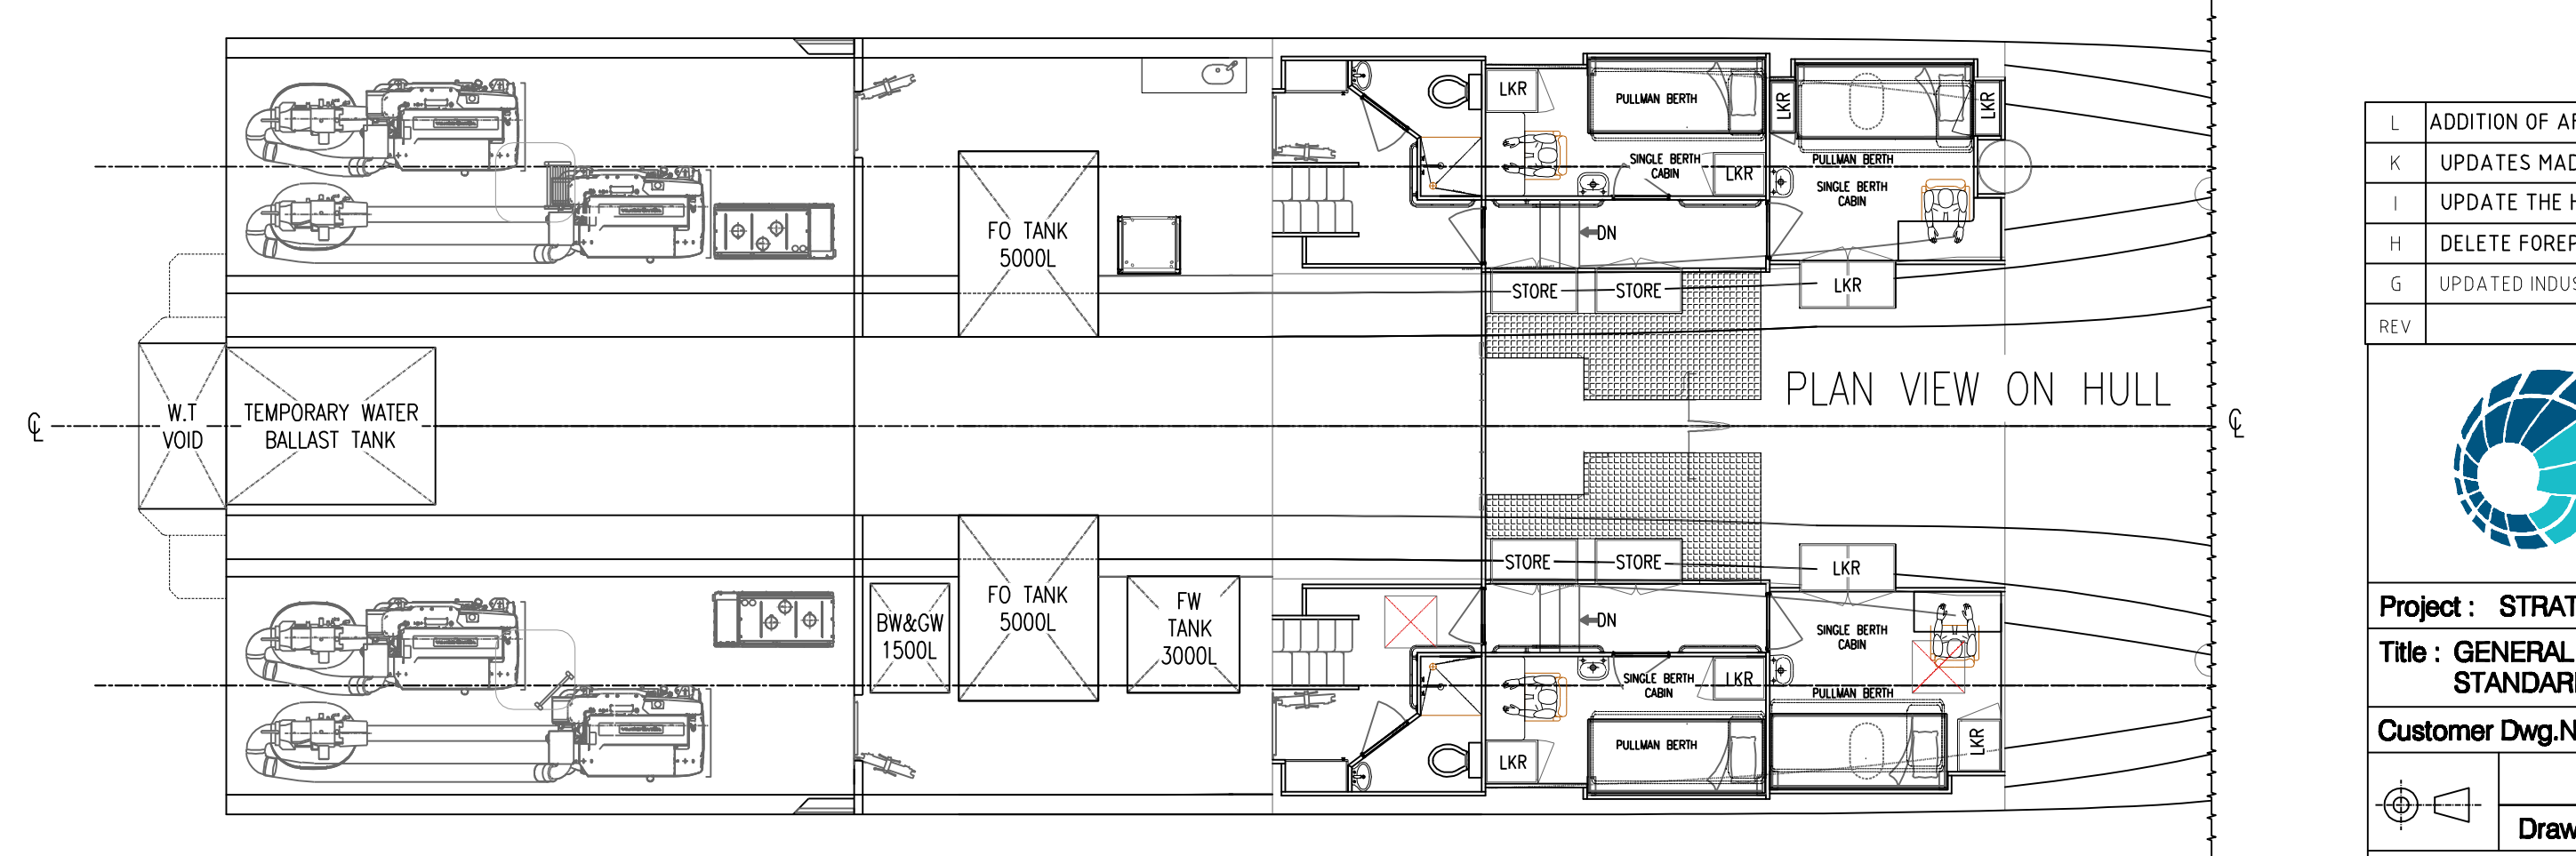

PLAN VIEW ON HULL

AS-BUILT

L	ADDITION OF AFT VOID OFF TRANSOM AT DECK LEVEL AND BASIN IN CABIN LOWER DECK	01/02/16	CWIT	JLAW
K	UPDATES MADE BY SHIPYARD - ADD 02 FWD VOID (P/S)	30/10/15	T.VU	B.TRAN
I	UPDATE THE HANDRAIL, DANGEROUS GOODS AREA	28/10/15	T.TA	B.TRAN
H	DELETE FOREPEAK TANK (P&S)	23/10/15	T.TA	B.TRAN
G	UPDATED INDUSTRIAL PERSONNEL INFORMATION	13/10/15	T.TA	B.TRAN
REV	DESCRIPTION	DATE	MOD BY	CHK BY



Project :	STRATCAT 26 - IPS	Chkd By :	CWIT	Chkd Date :	01/02/16
Title :	GENERAL ARRANGEMENT - OPIEOLK STANDARD - AFS	Dwg No :	NG972- 601-00-04		
Customer Dwg.No.	H202	Scale :	1:75 @ A1	Issue :	L
Drawn By :	MDIX	Scale :	1:75 @ A1	Issue :	L
			Sheet 1 of 1	Full Issue History on sheet 1.	

Building 14
Sharnbrook Quay
William Street
Southampton
SO14 5GL
UK
Tel: +44 (0)23 8022 8865
Email: admin@bmtng.com
URL: www.bmtng.com