




OUTBOARD PROFILE

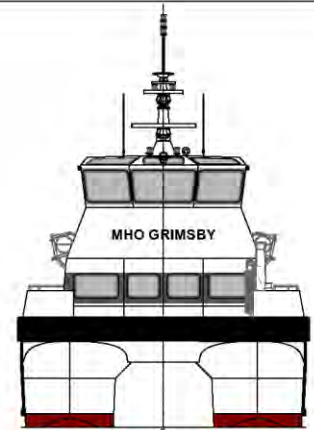

VIEW ON BOW

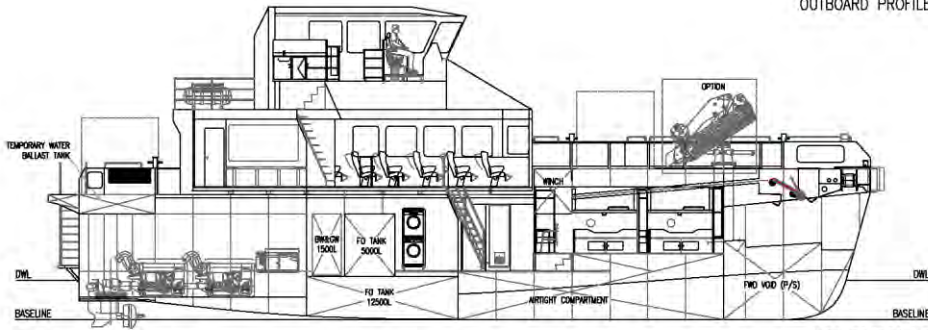

INBOARD PROFILE

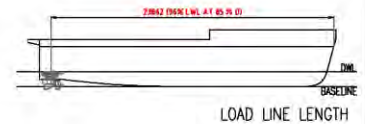

LOAD LINE LENGTH




**PRINCIPAL PARTICULARS**


LENGTH OVERALL:	28.2 m
LOAD LINE LENGTH:	23.8 m
LENGTH WATERLINE (DESIGN):	24.3 m
MAXIMUM MOULDED BEAM:	8.9 m
BEAM DEMIHULL CL - DEMIHULL CL:	5.95 m
HULL DESIGN DRAFT:	1.3 m
HULL SCANTLING DRAFT:	1.5 m
SCANTLING DRAFT (UNDERSIDE OF SKEG):	1.7 m
FUEL:	35000 L
FRESH WATER:	3000 L
BLACK WATER:	1500 L
CREW CAPACITY:	4
INDUSTRIAL PERSONNEL:	24 (WHERE THE NUMBER OF PASSENGERS CARRIED ON BOARD MAY NOT EXCEED 12)
CLASS:	LRS=100A1, SSC, WORKBOAT, CATAMARAN, HSC, GS MCH GERMAN
FLAG:	GERMAN
MAX DEADWEIGHT:	30t
AFT CARGO AREA:	27m <sup>2</sup>
FWD CARGO AREA:	50m <sup>2</sup>
DECK LOADING:	20m <sup>2</sup>
BALLAST TANK:	2800 L

**MACHINERY / PERFORMANCE**

MAIN ENGINES:	4x VOLVO PENTA IPS 800
SPEED @ 100%MCR 10t DWT:	27 kts
SPEED @ 85%MCR 10t DWT:	25 kts

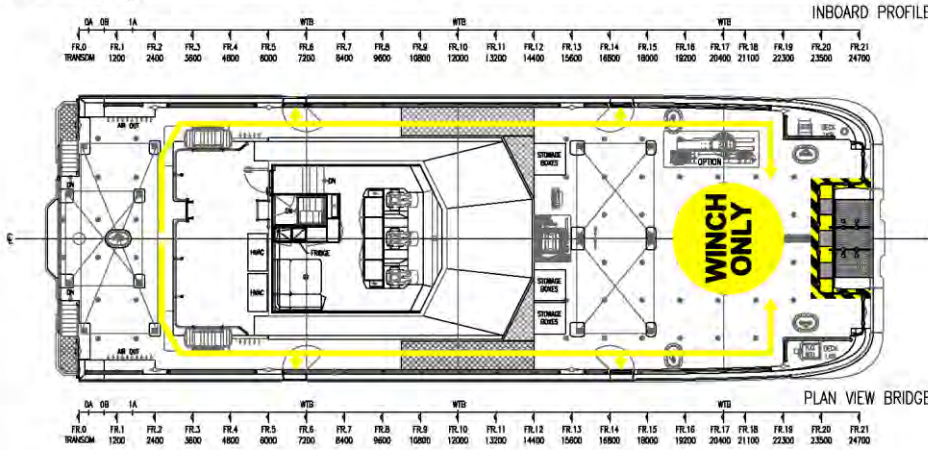

PLAN VIEW BRIDGE

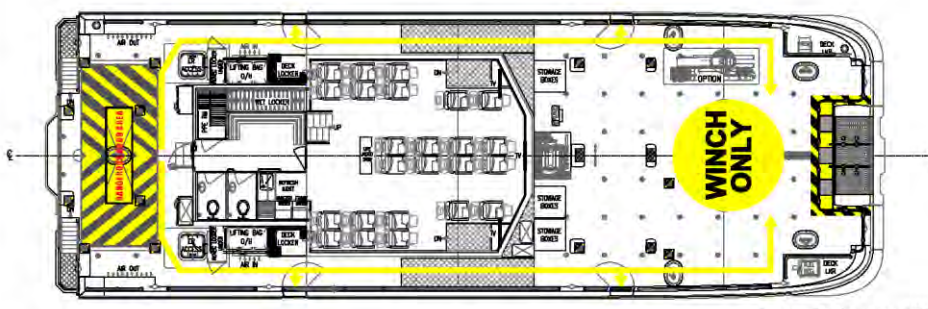

PLAN VIEW ON MAIN DECK



PLAN VIEW ON HULL



AS-BUILT

REV	DESCRIPTION	DATE	MOD. BY	CHK BY
L	ADDITION OF AFT VOID OFF TRANSON AT DECK LEVEL AND BASIN IN CABIN LOWER DECK	05/02/16	DMT	ILAW
K	UPDATES MADE BY SHIPYARD - ADD 92 FWD VOID (P/S)	26/10/15	T.VH	S.TRAN
I	UPDATE THE HANGAR, DANGEROUS GOODS AREA	29/10/15	T.TA	S.TRAN
H	DELETE FOREPEAK TANK (P/S)	23/10/15	T.TA	S.TRAN
G	UPDATED INDUSTRIAL PERSONNEL INFORMATION	13/10/15	T.TA	S.TRAN

Project:	STRATCAT 26 - FPS	Client By:	DMT	Client Date:	01/02/16
Title:	GENERAL ARRANGEMENT - OPILOK STANDARD - AFS	Dwg No.:	NG872-601-00-04	Issue:	L
Customer Dwg No.:	H202	Scale:	1:75 @ A1	Sheet:	1 of 1
Drawn By:	MOX	Scale:	1:75 @ A1	Issue:	L